


Date: 5/22/07


● FOR ELEVATIONS ABOVE 4,000 FT, USE THE VALUES IN PARENTHESIS

▲ Top of Rail = 28"  
See General Note 1  
Std Dwg C-10.03


F.H.W.A. REGION	STATE	PROJECT NO.	SHEET NO.	TOTAL SHEETS	AS BUILT
9	ARIZ.				

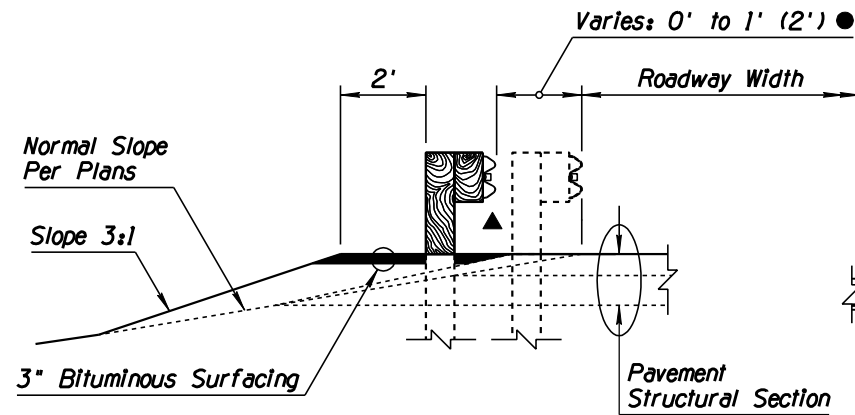


TYPE A SECTION

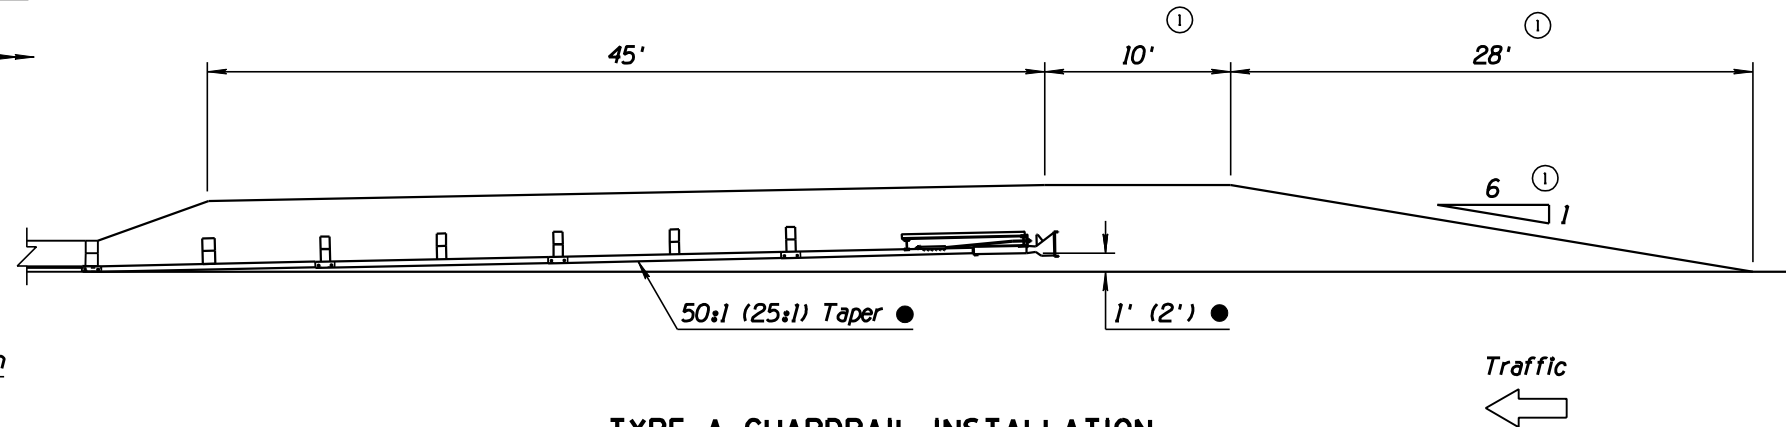

TYPE A GUARDRAIL INSTALLATION  
(FACE OF RAIL AT EDGE OF PAVEMENT)

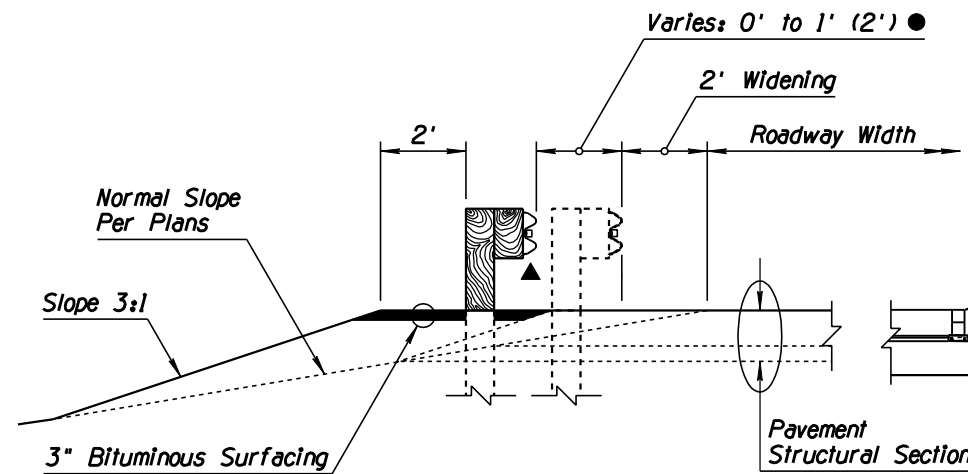

TYPE B SECTION

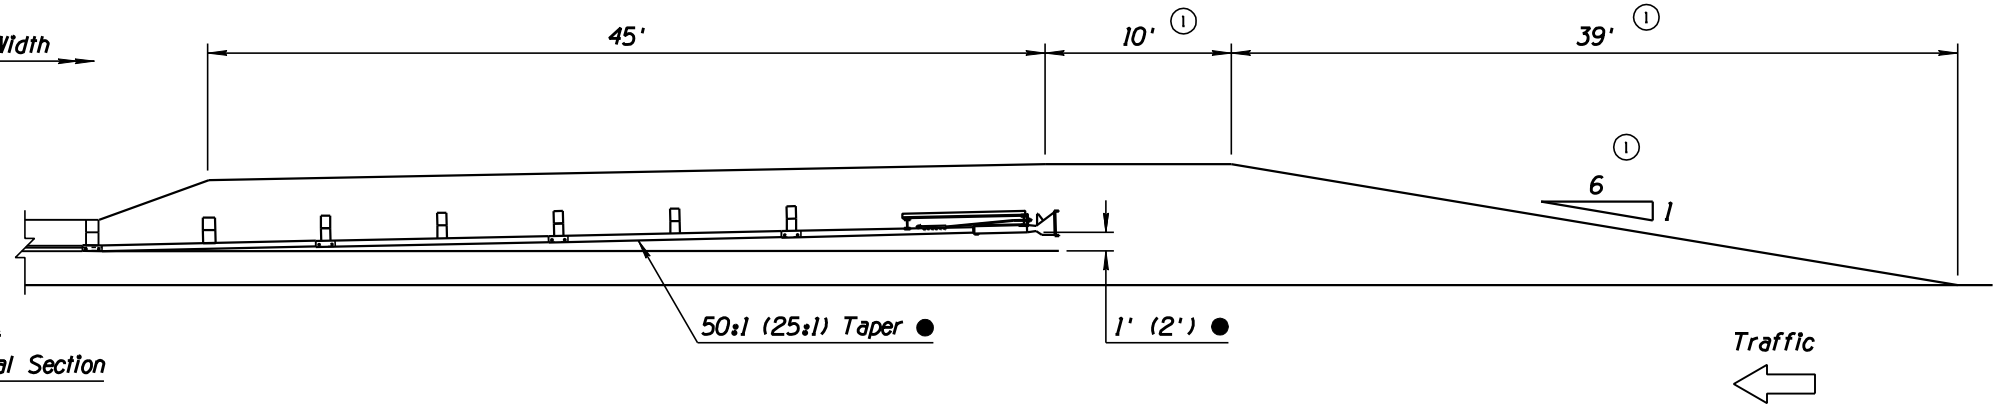

TYPE B GUARDRAIL INSTALLATION  
(FACE OF RAIL OFFSET 2' FROM NORMAL EDGE OF PAVEMENT)

## DETAIL

Sheet 2 of 2  
LAYOUT FOR ET-PLUS  
HBA POSTS  
(AC PAVEMENT)

DESIGN APPROVED <b>Kenneth R. Cooper</b>		ARIZONA DEPARTMENT OF TRANSPORTATION INTERMODAL TRANSPORTATION DIVISION ROADWAY GROUP PLANS DETAIL	
APPROVED FOR DISTRIBUTION <b>Mary Viparina</b>			
ROUTE	LOCATION	SHEET	OF
TRACS NO.		___ OF ___	

Note to Designer:  
The information presented in this Roadway Plans Detail is for general use.  
Designers should satisfy themselves that their project site conditions are  
appropriate for use of this drawing. Contents within the inner border shall  
not be altered, except for the addition of the Detail designation.

NO	DESCRIPTION OF REVISIONS	MADE BY	DATE
1	REISSUED DRAWING WITH MODIFIED APPROACH TAPER	RLF	5/22/07
2			
3			
4			